

www.gotoitsi.com


COPYRIGHT 2011 (C)



LAWRENCE
BERKELEY
NATIONAL LAB
6401 HOLLIS STREET,
SUITE 175
EMERYVILLE, CA

AS-BUILT

THIS DRAWING CONTAINS CONFIDENTIAL PROPRIETARY INFORMATION OF INTELLIGENT TECHNOLOGIES & SERVICES, INC. ALL RIGHTS ARE EXPRESSLY RESERVED. IT IS SUBMITTED UNDER A TRUST RELATIONSHIP FOR YOUR USE IN APPROVAL, CONSTRUCTION OR BIDDING PROCEDURES. THIS DRAWING IS NOT TO BE USED FOR ANY OTHER PURPOSE NOR ITS CONTENTS REVEALED TO ANYONE NOR COPIED IN WHOLE OR IN PART NOR ITS DESIGN FEATURES USED WITHOUT OUR WRITTEN CONSENT. RETURN WHEN NO LONGER REQUIRED OR I/ON BEHALF

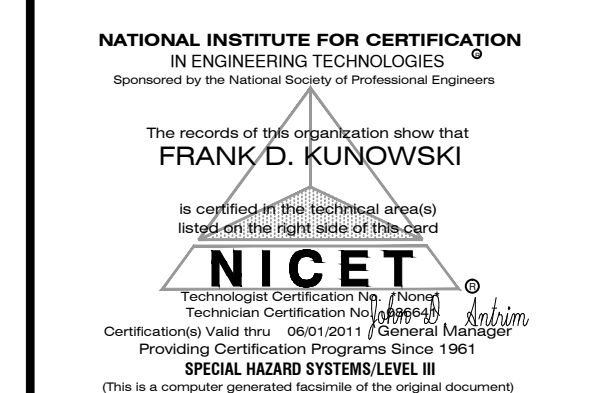

REV	DESCRIPTION	DATE
	ISSUED FOR REVIEW	06 / 16 / 11
	AS-BUILT	7/6/2011


Designer: A. LOPEZ
Sales: B. DIGRAZIA
Project Mgr: C. ROARK

SHEET TITLE:

MEZZANINE FIRE
ALARM AUDIBLE /
VISUAL DEVICE
LAYOUT

PROJECT NO. C-5173

SHEET: FA-3

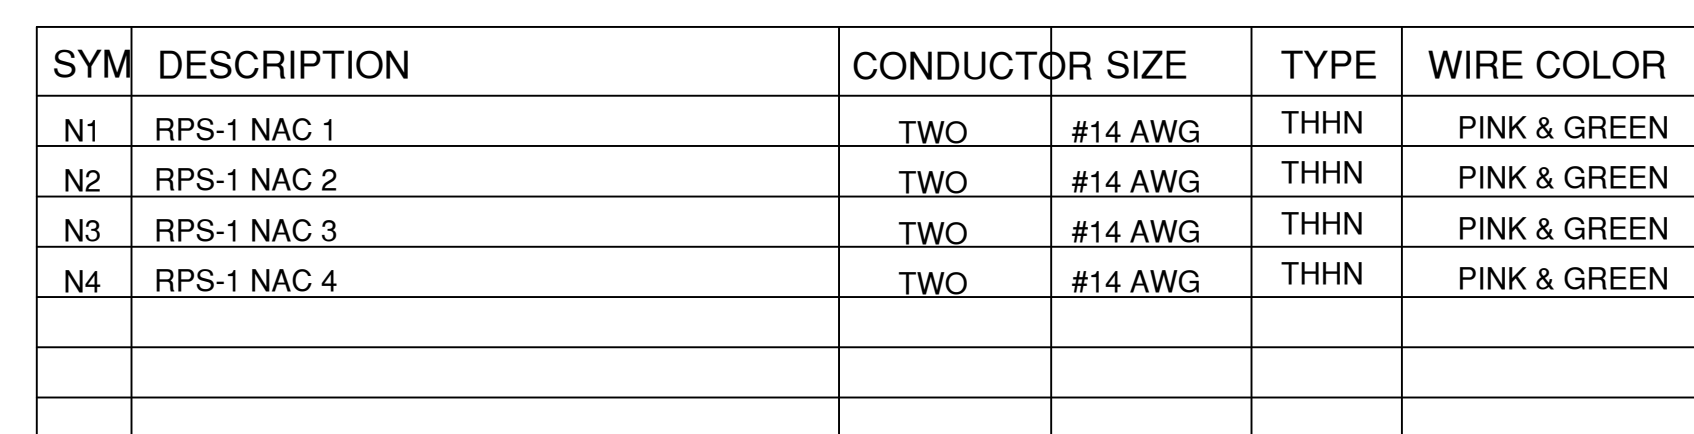

LBNL DRAWING NO.
4B971E007